
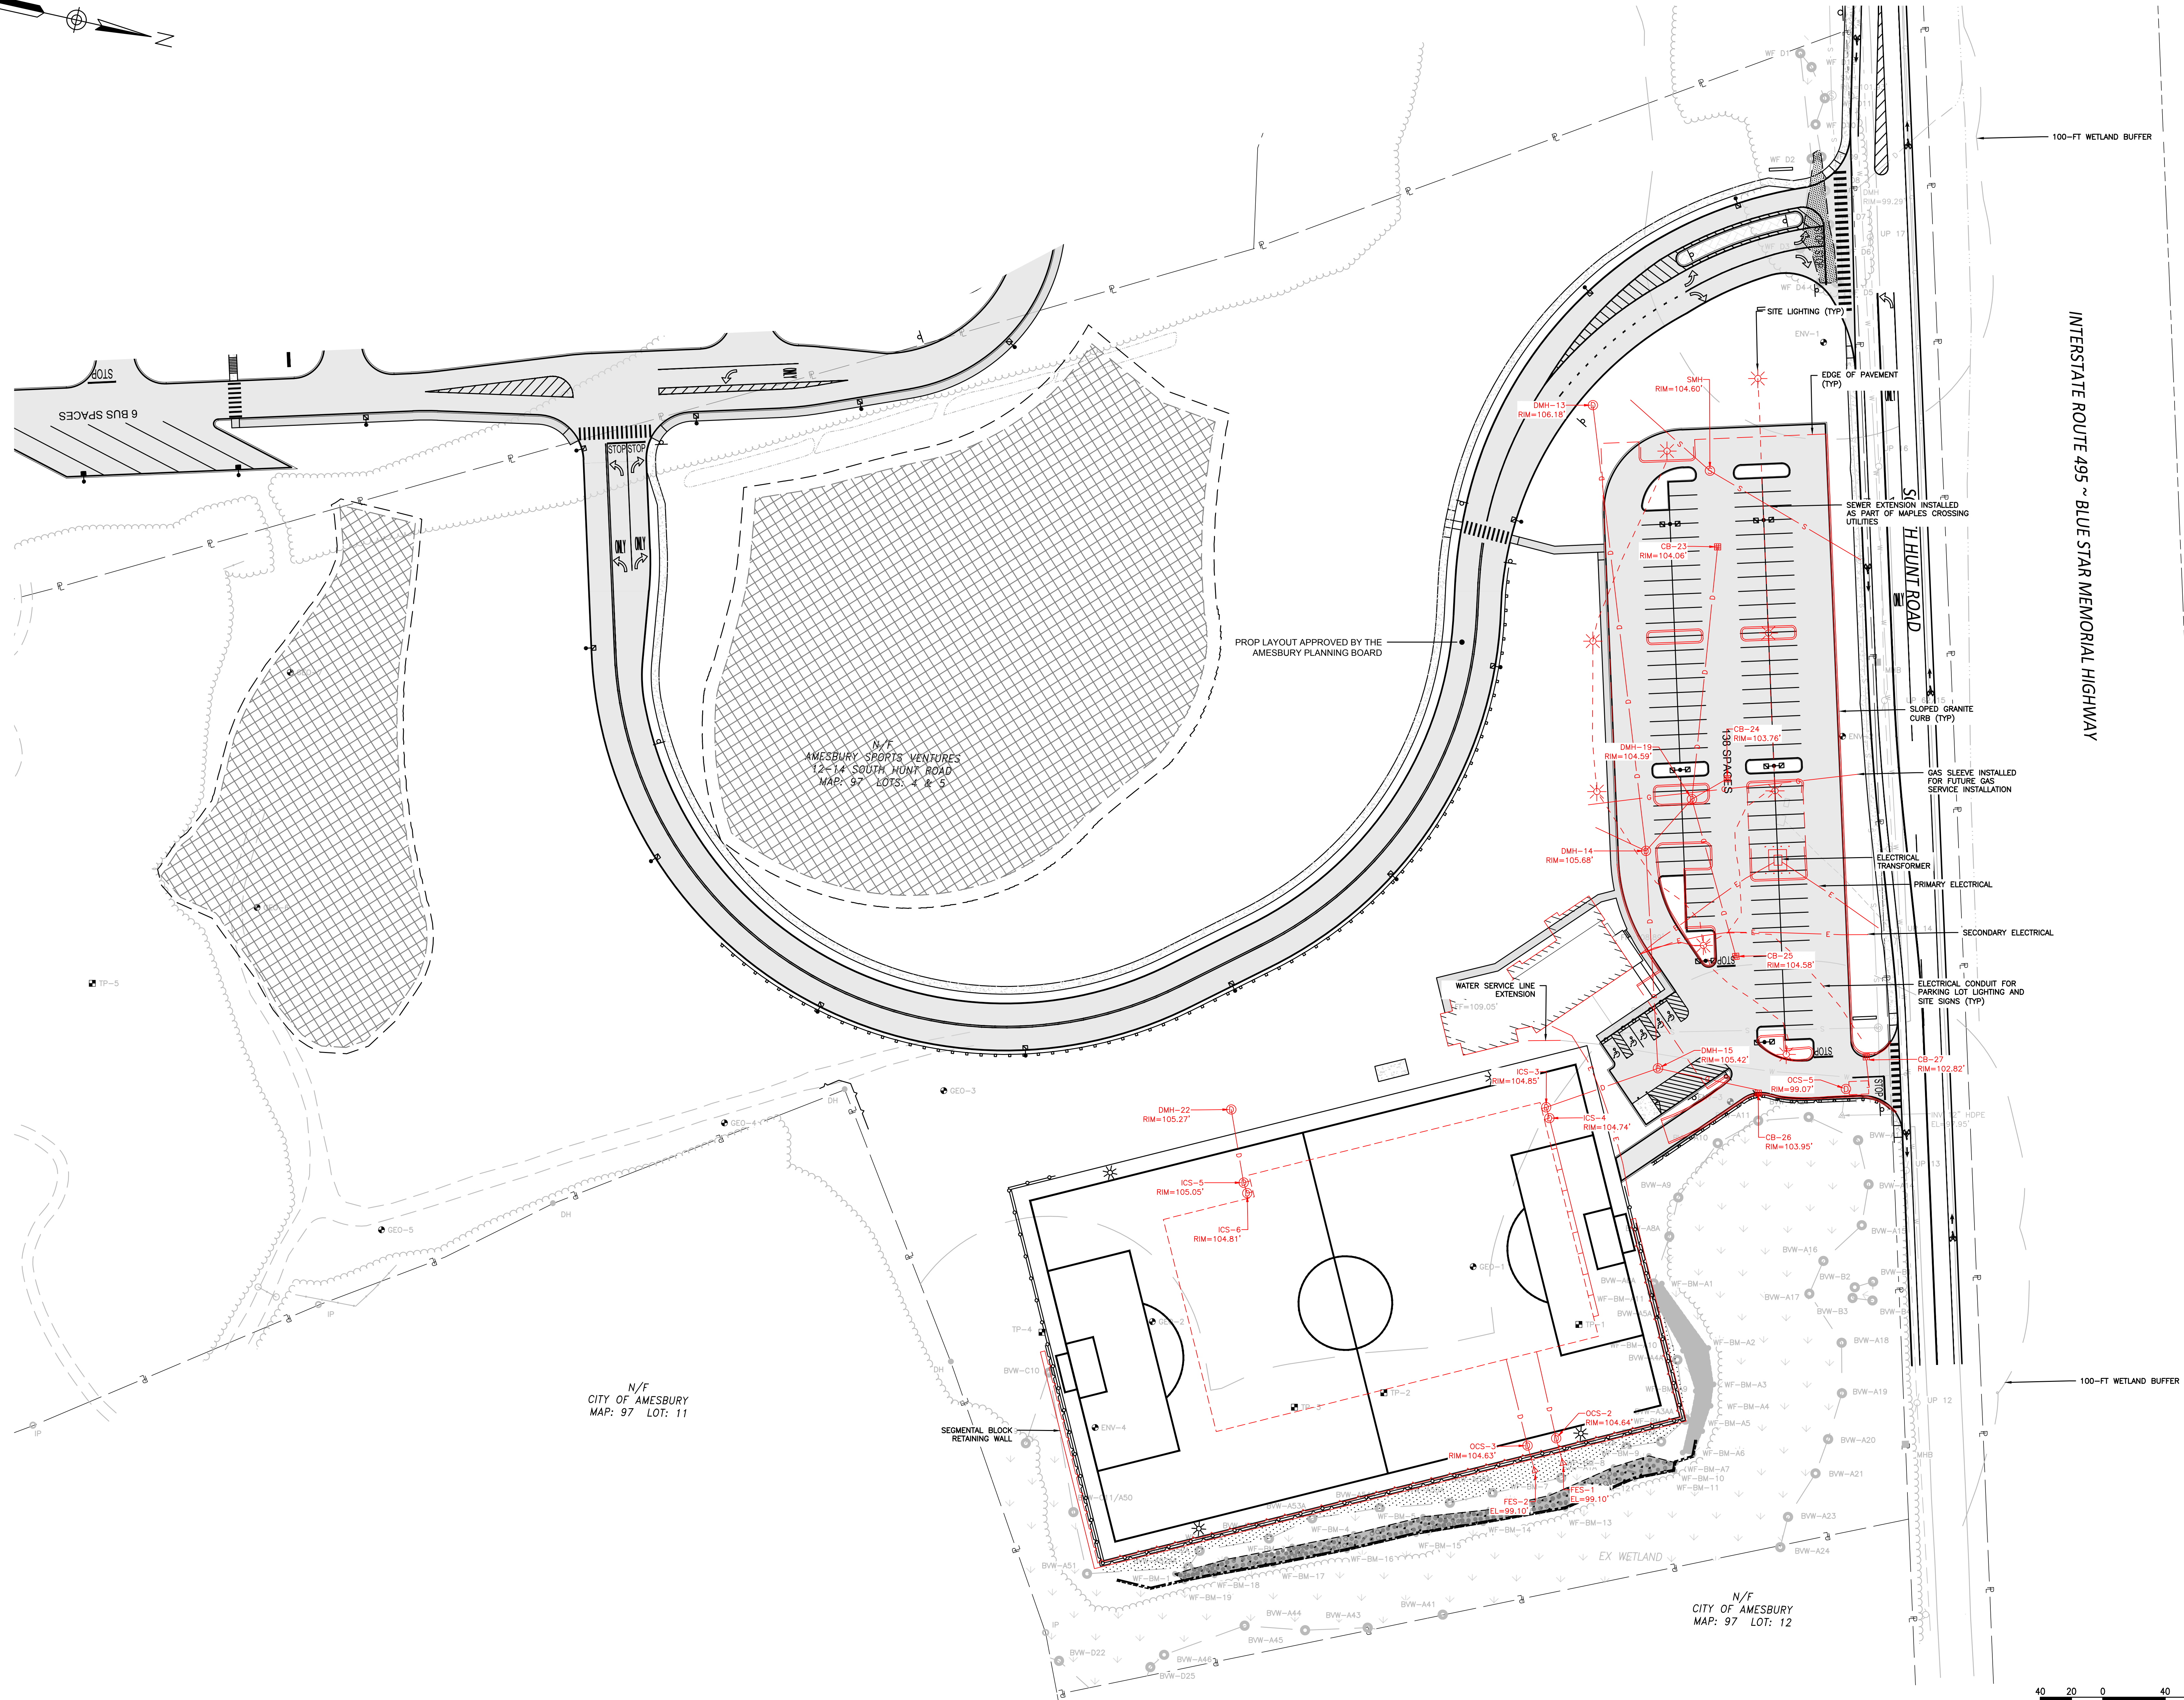


\\weston\local\WSE\Projects\Private\Global Property Developers Corporation\Sports Park\Amesbury\090403_C-3\T\TV100 - As-Built.dwg

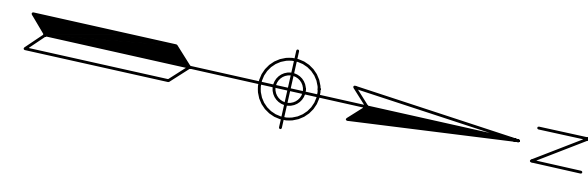

Project:
AMESBURY SPORTS
PARK
12-14 SOUTH HUNT ROAD
AMESBURY, MA 01913

Developer:
GLOBAL PROPERTY
DEVELOPERS CORPORATION
GLOBAL PROPERTY
DEVELOPERS
CORPORATION
80 1ST STREET
BRIDGEWATER, MA 02324

Weston & Sampson
Weston & Sampson Engineers, Inc.
55 Walkers Brook Dr. Suite 100,
Reading, MA 01860
978.532.1900 800.SAMPSON
www.westonandsampson.com

Consultants:

Revisions:		
No.	Date	Description

Seal:

COA:
COPYRIGHT © 2021 BY WESTON & SAMPSON.
THIS DRAWING HAS BEEN PREPARED FOR THE
EXCLUSIVE USE OF THE CLIENT & PROJECT NAME
LISTED ON THIS DRAWING ONLY.
REPRODUCTION, RELEASE OF UTILIZATION OF THE
DRAWING CONTENT BY OTHER CLIENTS / FIRMS AND
ON OTHER PROJECTS IS PROHIBITED BY LAW.
WESTON & SAMPSON, RETAINS THE EXCLUSIVE USE
OF THE INTELLECTUAL PROPERTY CONTAINED
HEREIN.

Issued For:

**PERMITTING - NOT
FOR CONSTRUCTION**

Scale: AS SHOWN
Date: NOVEMBER 19, 2021
Drawn By: AKG
Reviewed By: JIP
Approved By: JIP
W&S Project No.: 2190336
W&S File No.:

Drawing Title:

AS-BUILT PLAN

Sheet Number:

V100

COPYRIGHT 2021 WESTON & SAMPSON